



REVISIONS						
ZONE	LTR	DESCRIPTION	DATE	DRAFT	CHK'D	APP'D
	A	AS BUILT	4/11/73	RAF	24	

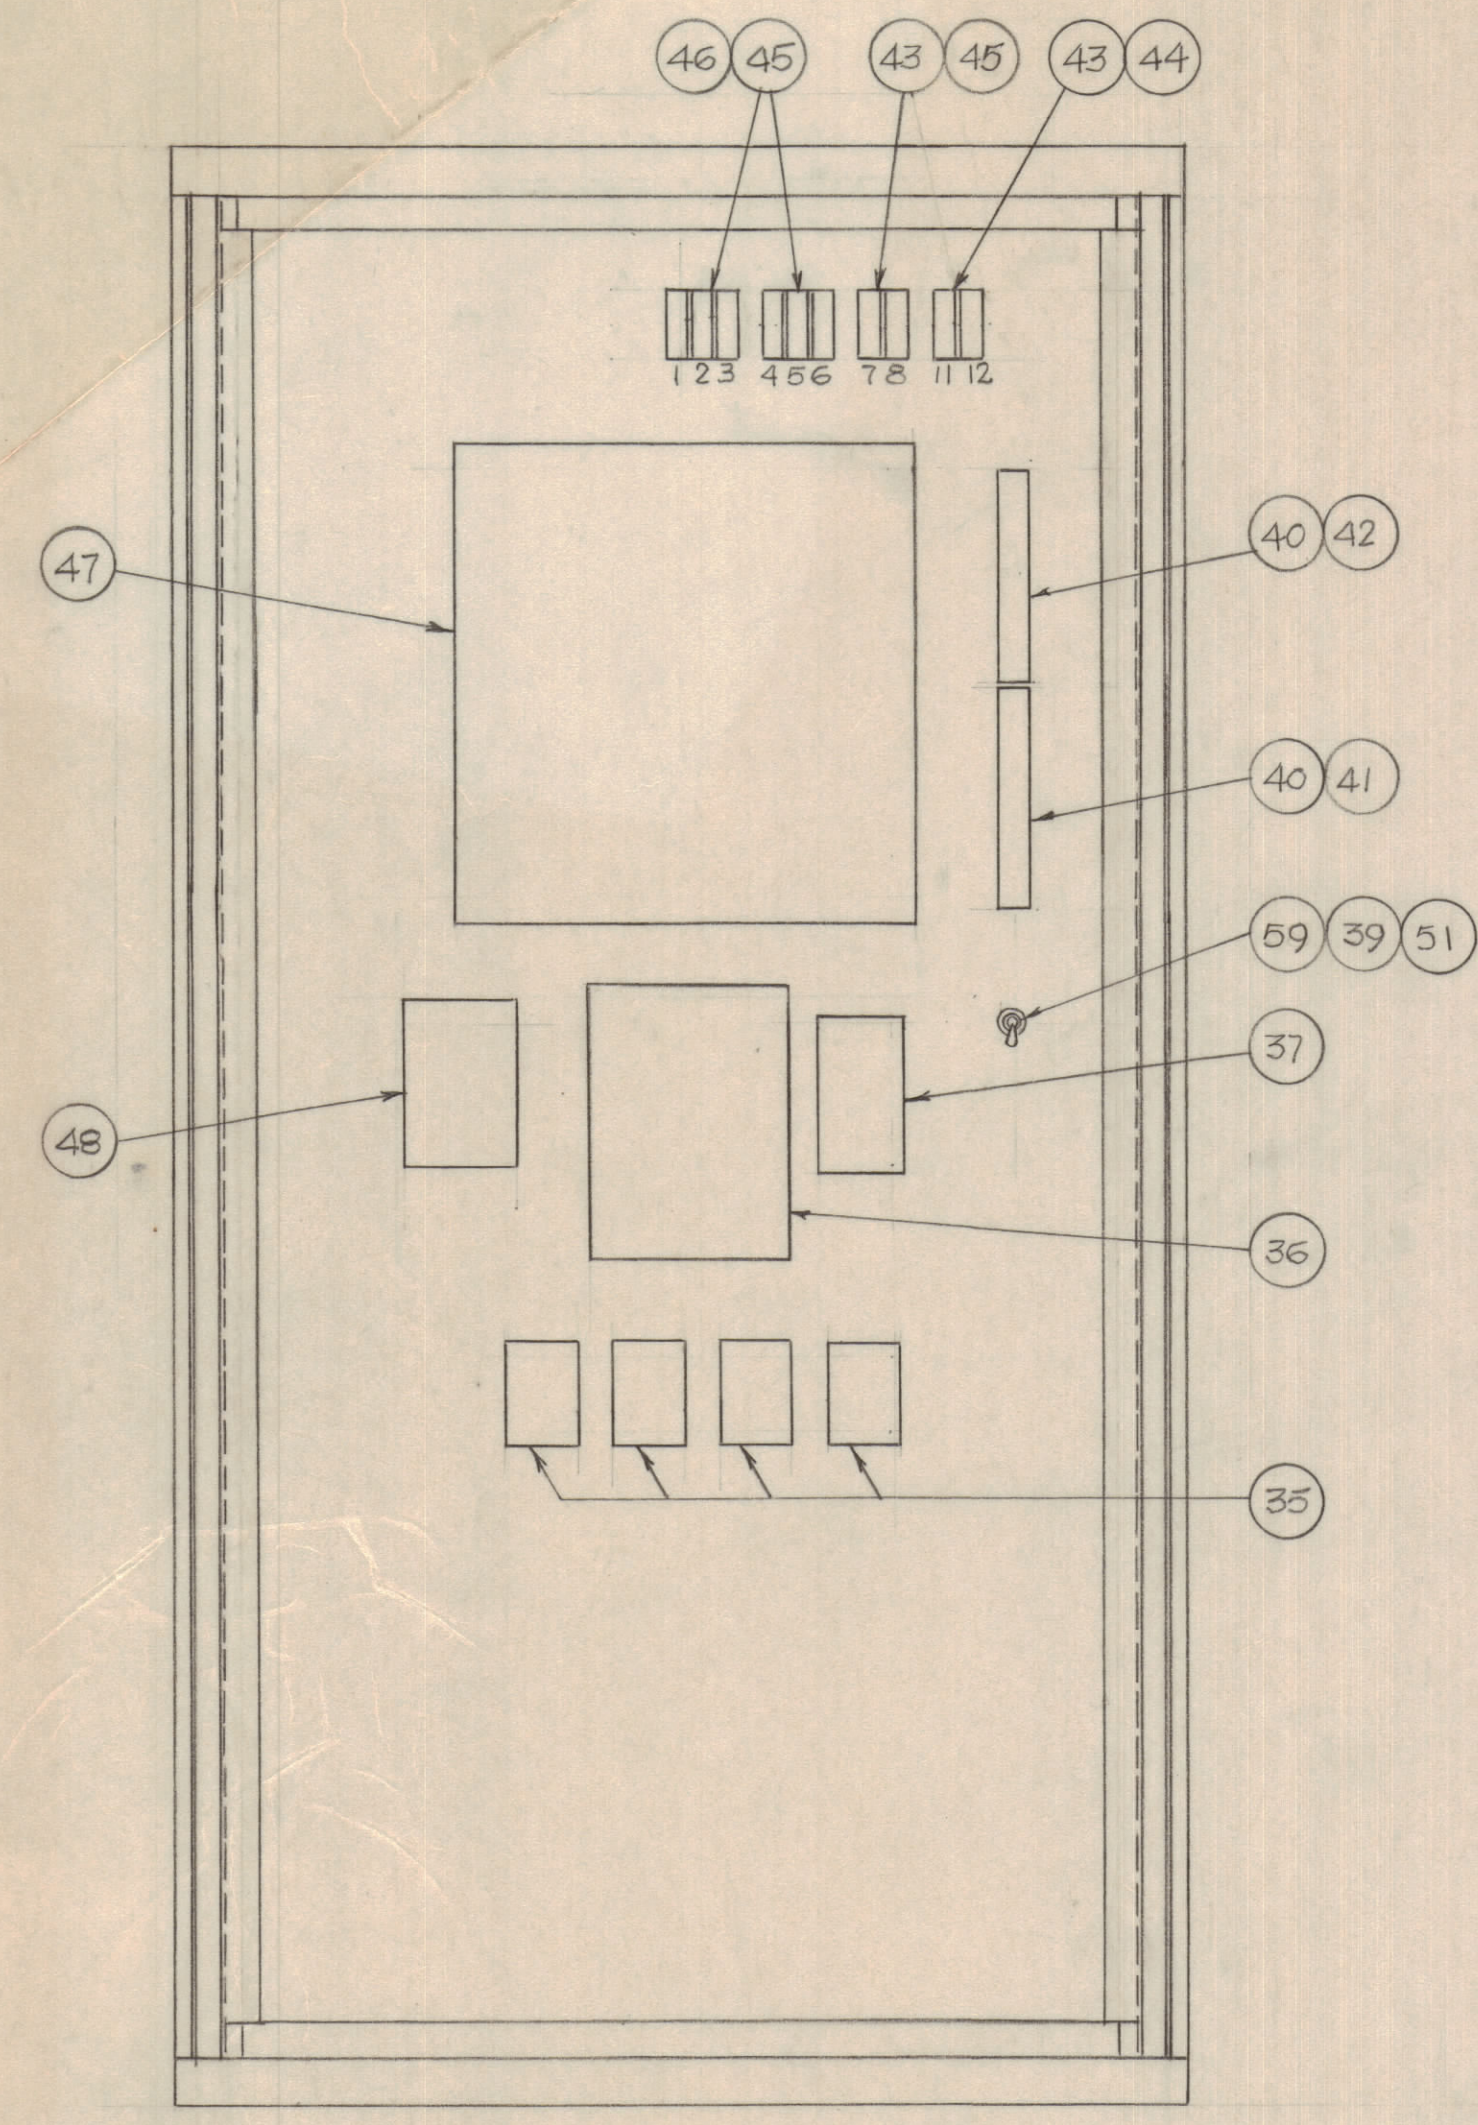

INTERIOR - RIGHT SIDE

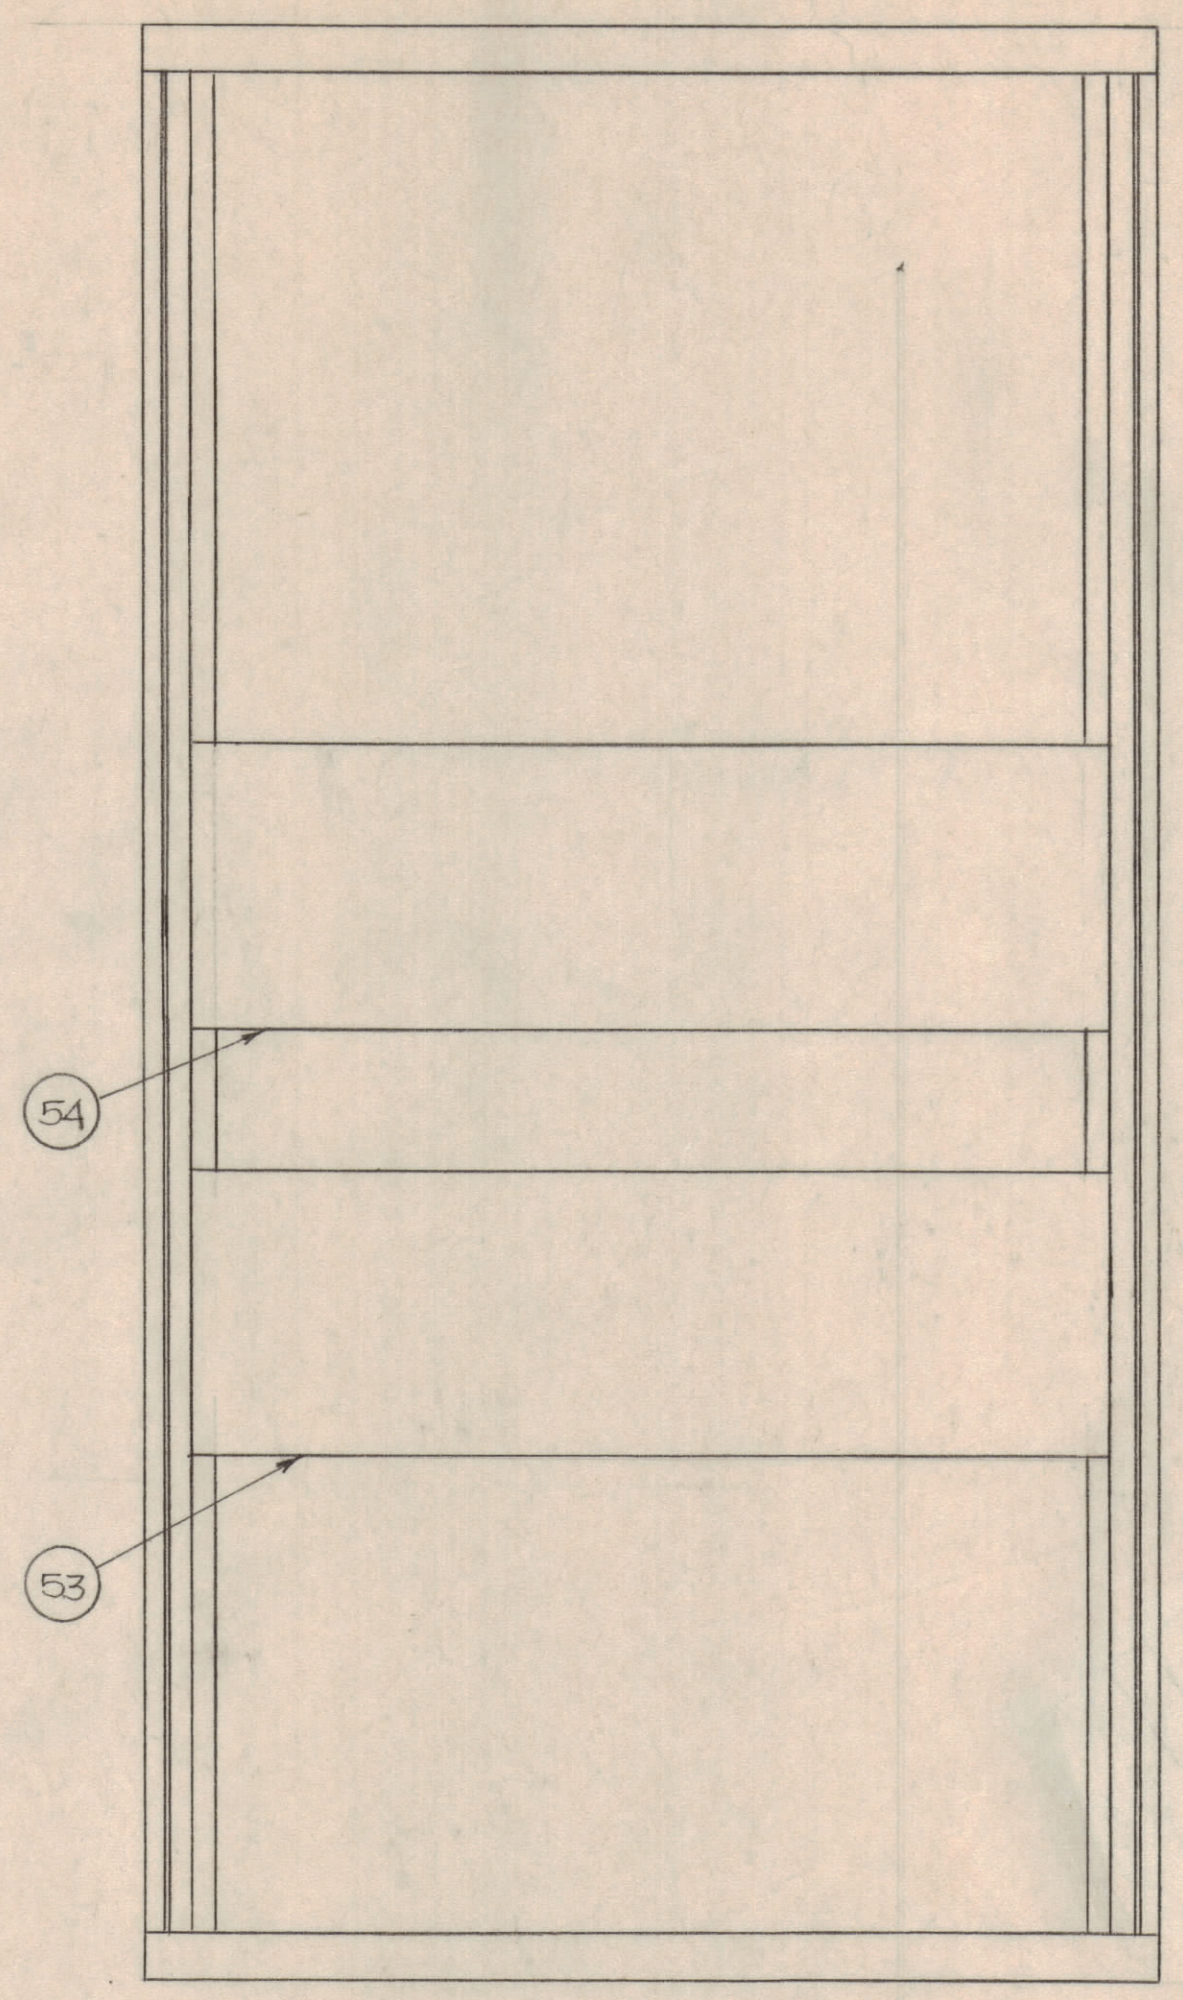

INTERIOR - LEFT SIDE

QTY REQ	QTY REQ	QTY REQ	ITEM	PART NO.	MANUFACTURER	DESCRIPTION	SYM
PARTS LIST							
DRAWN FERNANDEZ				DATE 1/18/73	THE TMC SYSTEMS AND POWER CORPORATION SPRINGFIELD, VIRGINIA		
CHECKED <i>MA</i>				DATE 6-14-73			
D. ENG.				DATE	PARTS PLACEMENT AC CONTROL CABINET 277/480VAC, 425 KW		
P. ENG. <i>CRB</i>				DATE 14-JUN-73			
P. MGR.				DATE	SIZE CODE IDENT NO DWG. NO. REV D 24146 AX730 A		
CHIEF, ENG. DEPT.				DATE			
QA <i>[Signature]</i>				DATE 6-15-73	SCALE 1/8" = 1"		
FAA QRO <i>G. White</i>				DATE 6-26-73			

INTERPRET DRAWING PER LISTED DOCUMENTS

UNLESS OTHERWISE SPECIFIED DIMENSIONS ARE IN INCHES AND INCLUDE CHEMICALLY APPLIED OR PLATED FINISHES REMOVE ALL BURRS AND SHARP EDGES

TOLERANCES ON FRACTIONS ANGLES DECIMALS

MATERIAL

FINISH

EGS500B

APPLICATION

NOTICE TO PERSONS RECEIVING THIS DRAWING THE TMC SYSTEMS AND POWER CORPORATION claims proprietary right in the material disclosed hereon. This drawing is issued in confidence for engineering information only and may not be reproduced or used to manufacture anything shown hereon without permission from THE TMC SYSTEMS AND POWER CORPORATION to the user. This drawing is loaned for mutual assistance and is subject to recall at any time.

m56144