


| REVISIONS | | | | | | |
|-----------|-----|-----------------------------|---------|-------|-------|-------|
| ZONE | LTR | DESCRIPTION | DATE | DRAWN | CHK'D | APP'D |
| A | | REVISED AS BUILT | 3-17-70 | RM | CEB | CEB |
| B | | ADDED CAPACITOR ACROSS BDOB | 2-11-71 | RM | CEB | CEB |

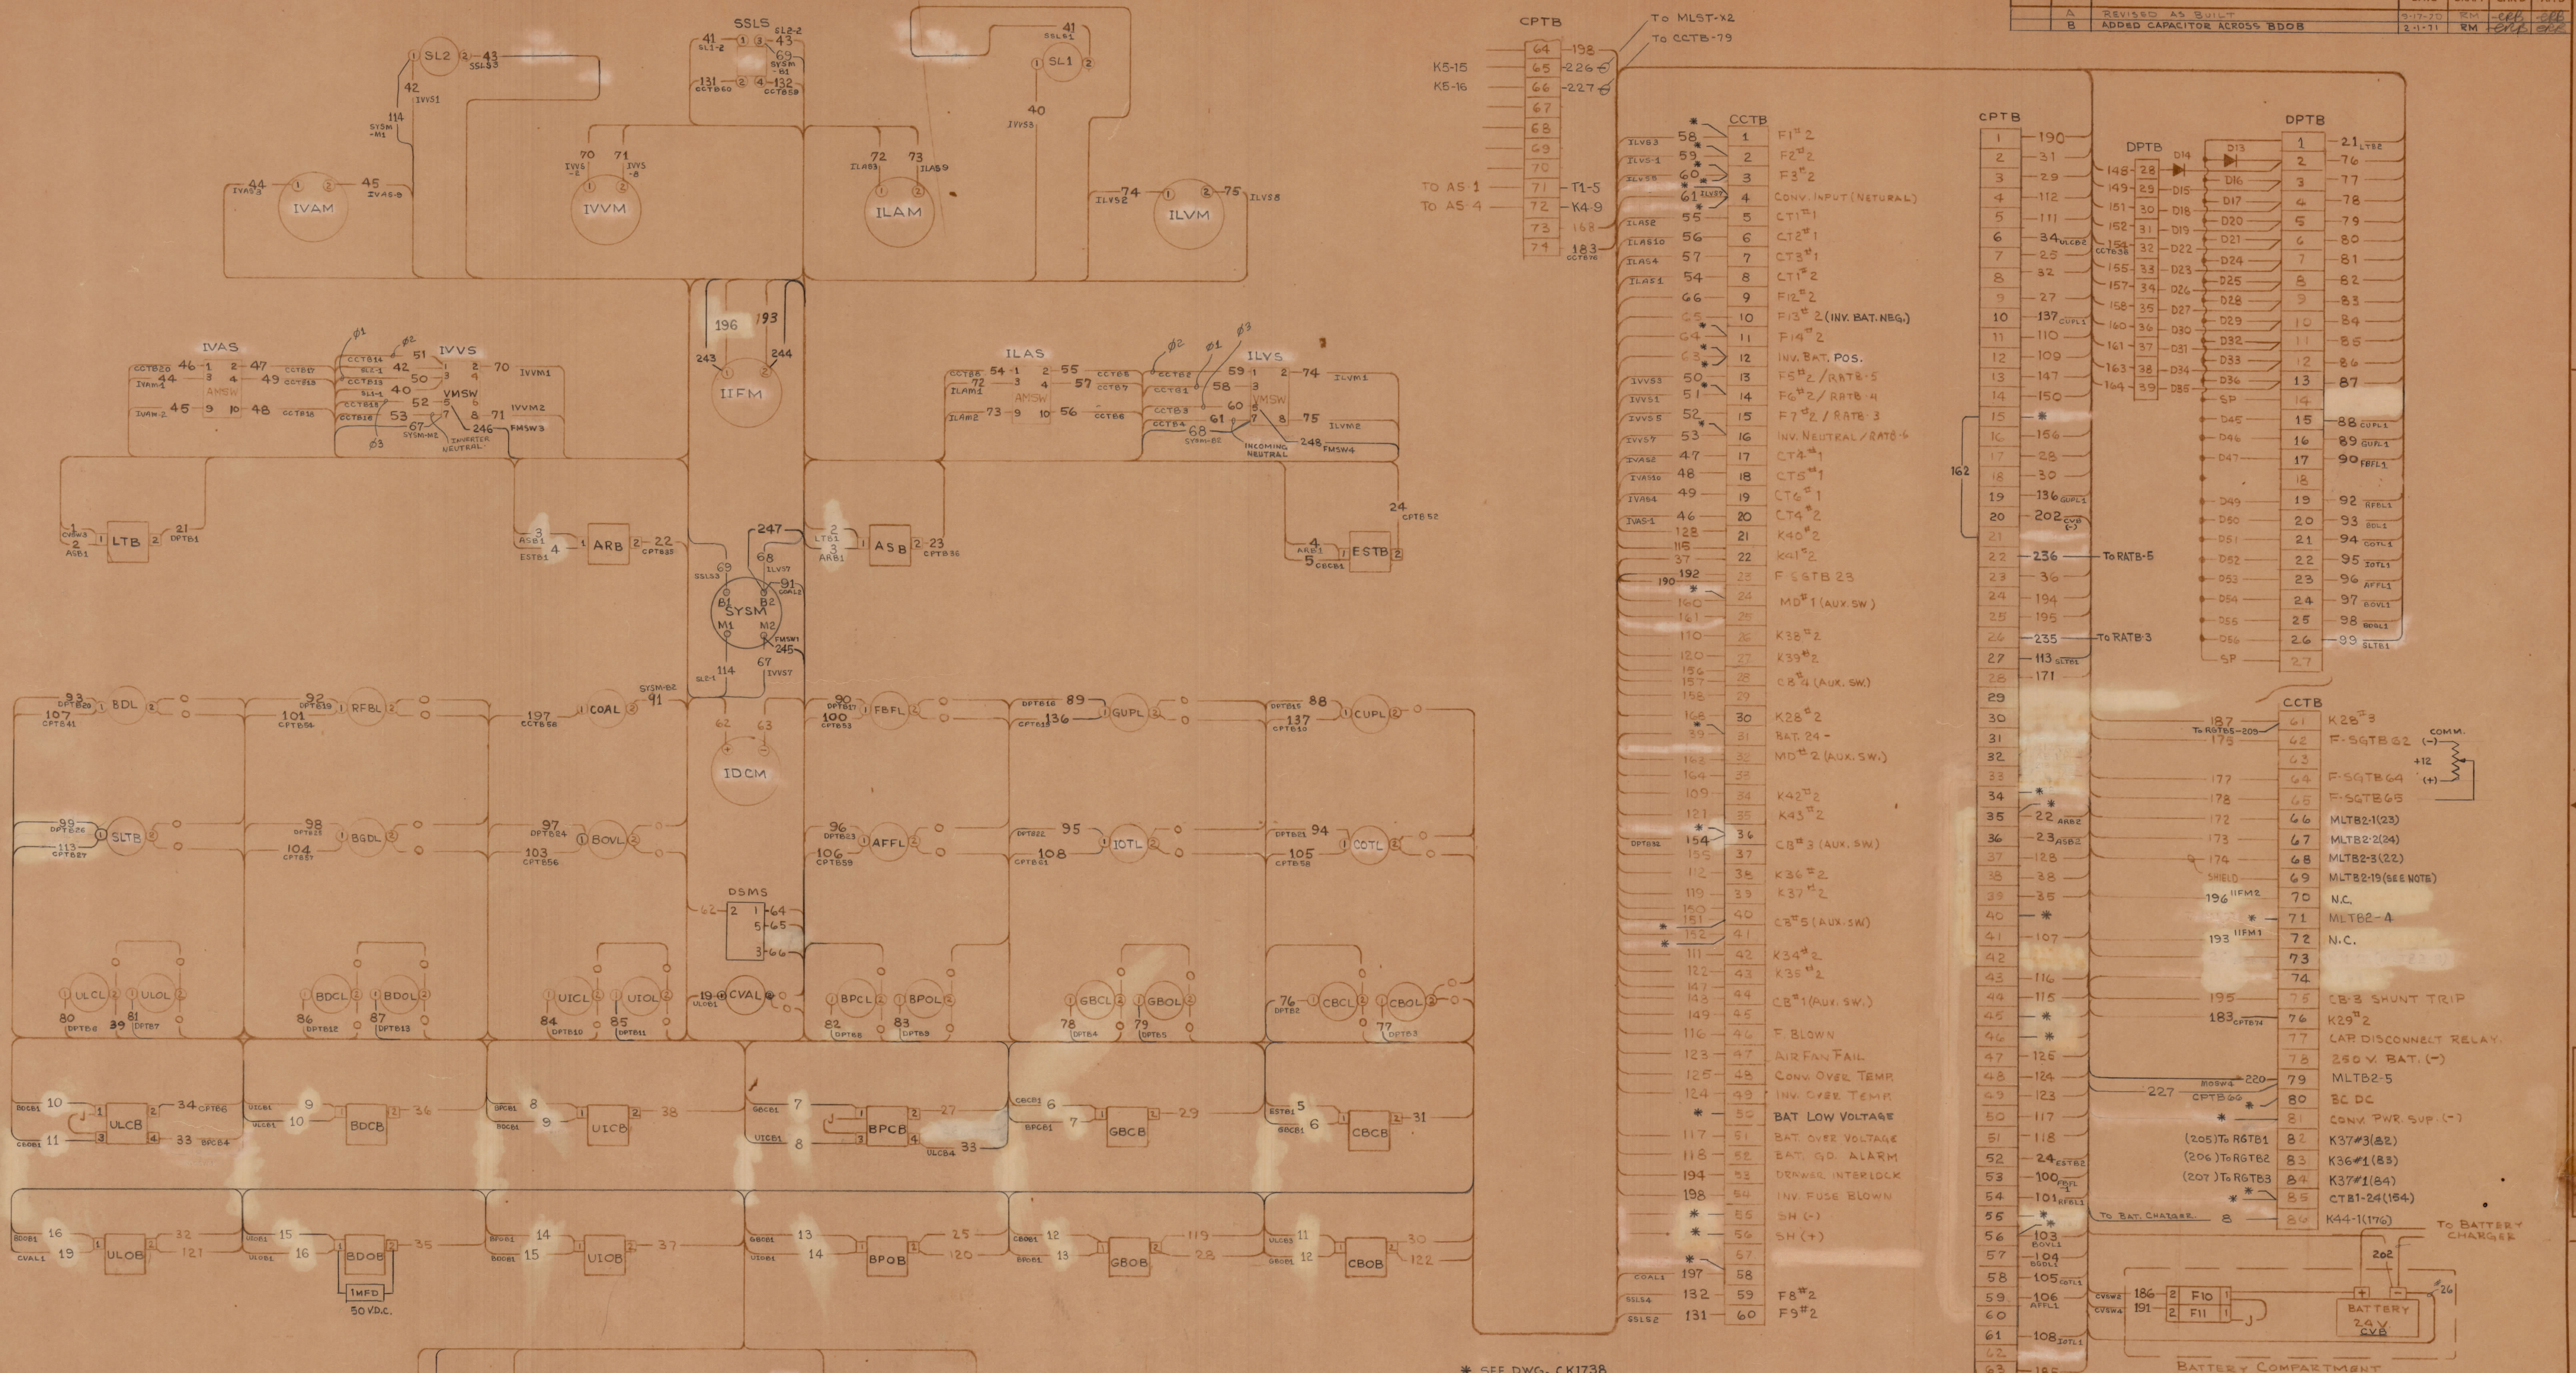

* SEE DWG. CK1738

USED ON 75 & 90 KVA.

| QTY REQ | QTY REQ | QTY REQ | ITEM | PART NO. | MANUFACTURER | DESCRIPTION | SYM |
|---|---------------|----------|------|----------|--------------|-------------|-----|
| | | | | | | | |
| PARTS LIST | | | | | | | |
| THE TMC SYSTEMS AND POWER CORPORATION SPRINGFIELD, VIRGINIA | | | | | | | |
| CONTROL/DOOR WIRING DIAGRAM | | | | | | | |
| SIZE | CODE IDENT NO | DWG. NO. | REV | | | | |
| D | 24146 | CK1718 | B | | | | |
| SCALE | | | | SHEET | OF | | |

INTERPRET DRAWING PER LISTED DOCUMENTS

UNLESS OTHERWISE SPECIFIED DIMENSIONS ARE IN INCHES AND INCLUDE CHEMICALLY APPLIED OR PLATED FINISHES REMOVE ALL BURRS AND SHARP EDGES

TOLERANCES ON

| | | |
|-----------|--------|----------|
| FRACTIONS | ANGLES | DECIMALS |
| | | |

MATERIAL

FINISH

NOTICE TO PERSONS RECEIVING THIS DRAWING

THE TMC SYSTEMS AND POWER CORPORATION claims proprietary right in the material disclosed herein. This drawing is issued in confidence for engineering information only and may not be reproduced or used to manufacture anything shown herein without permission from THE TMC SYSTEMS AND POWER CORPORATION to the user. This drawing is loaned for mutual assistance and is subject to recall at any time.

