




REVISIONS						
ZONE	LTR	DESCRIPTION	DATE	DRAFT	CHK'D	APP'D
	A	CORRECTED CEILING LIGHT DIMENSIONS	4/23/73	DMF		
	B	CORRECTED DIMENSIONS AS BUILT	1/20/73	ESF	EG	

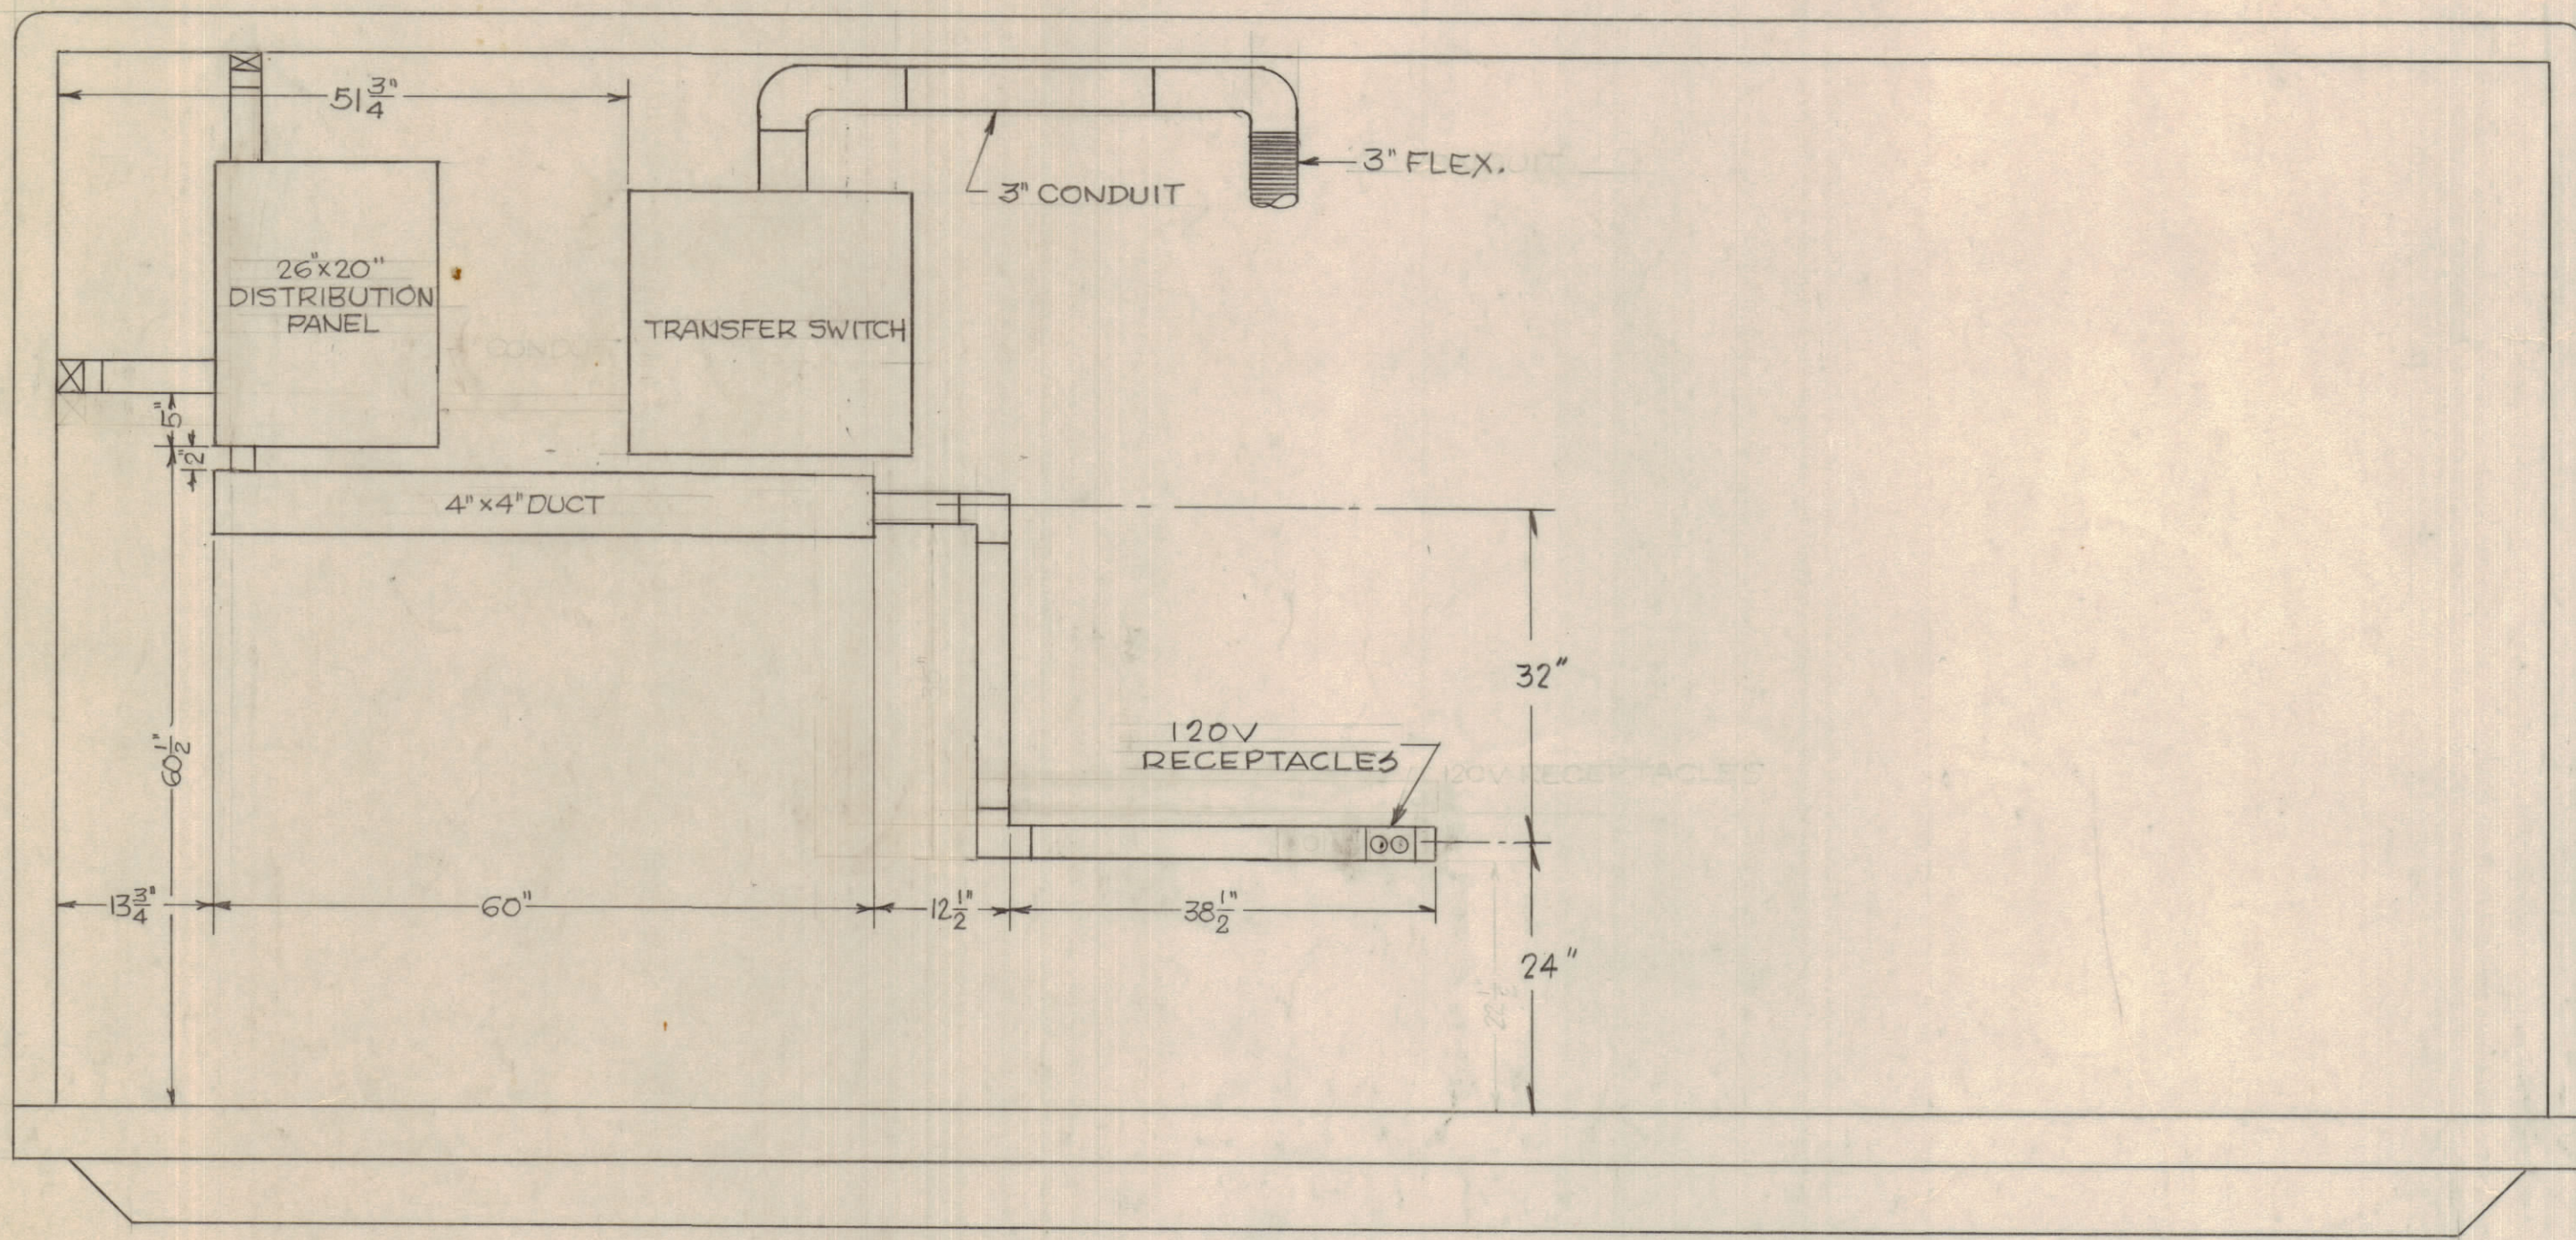


CURBSIDE

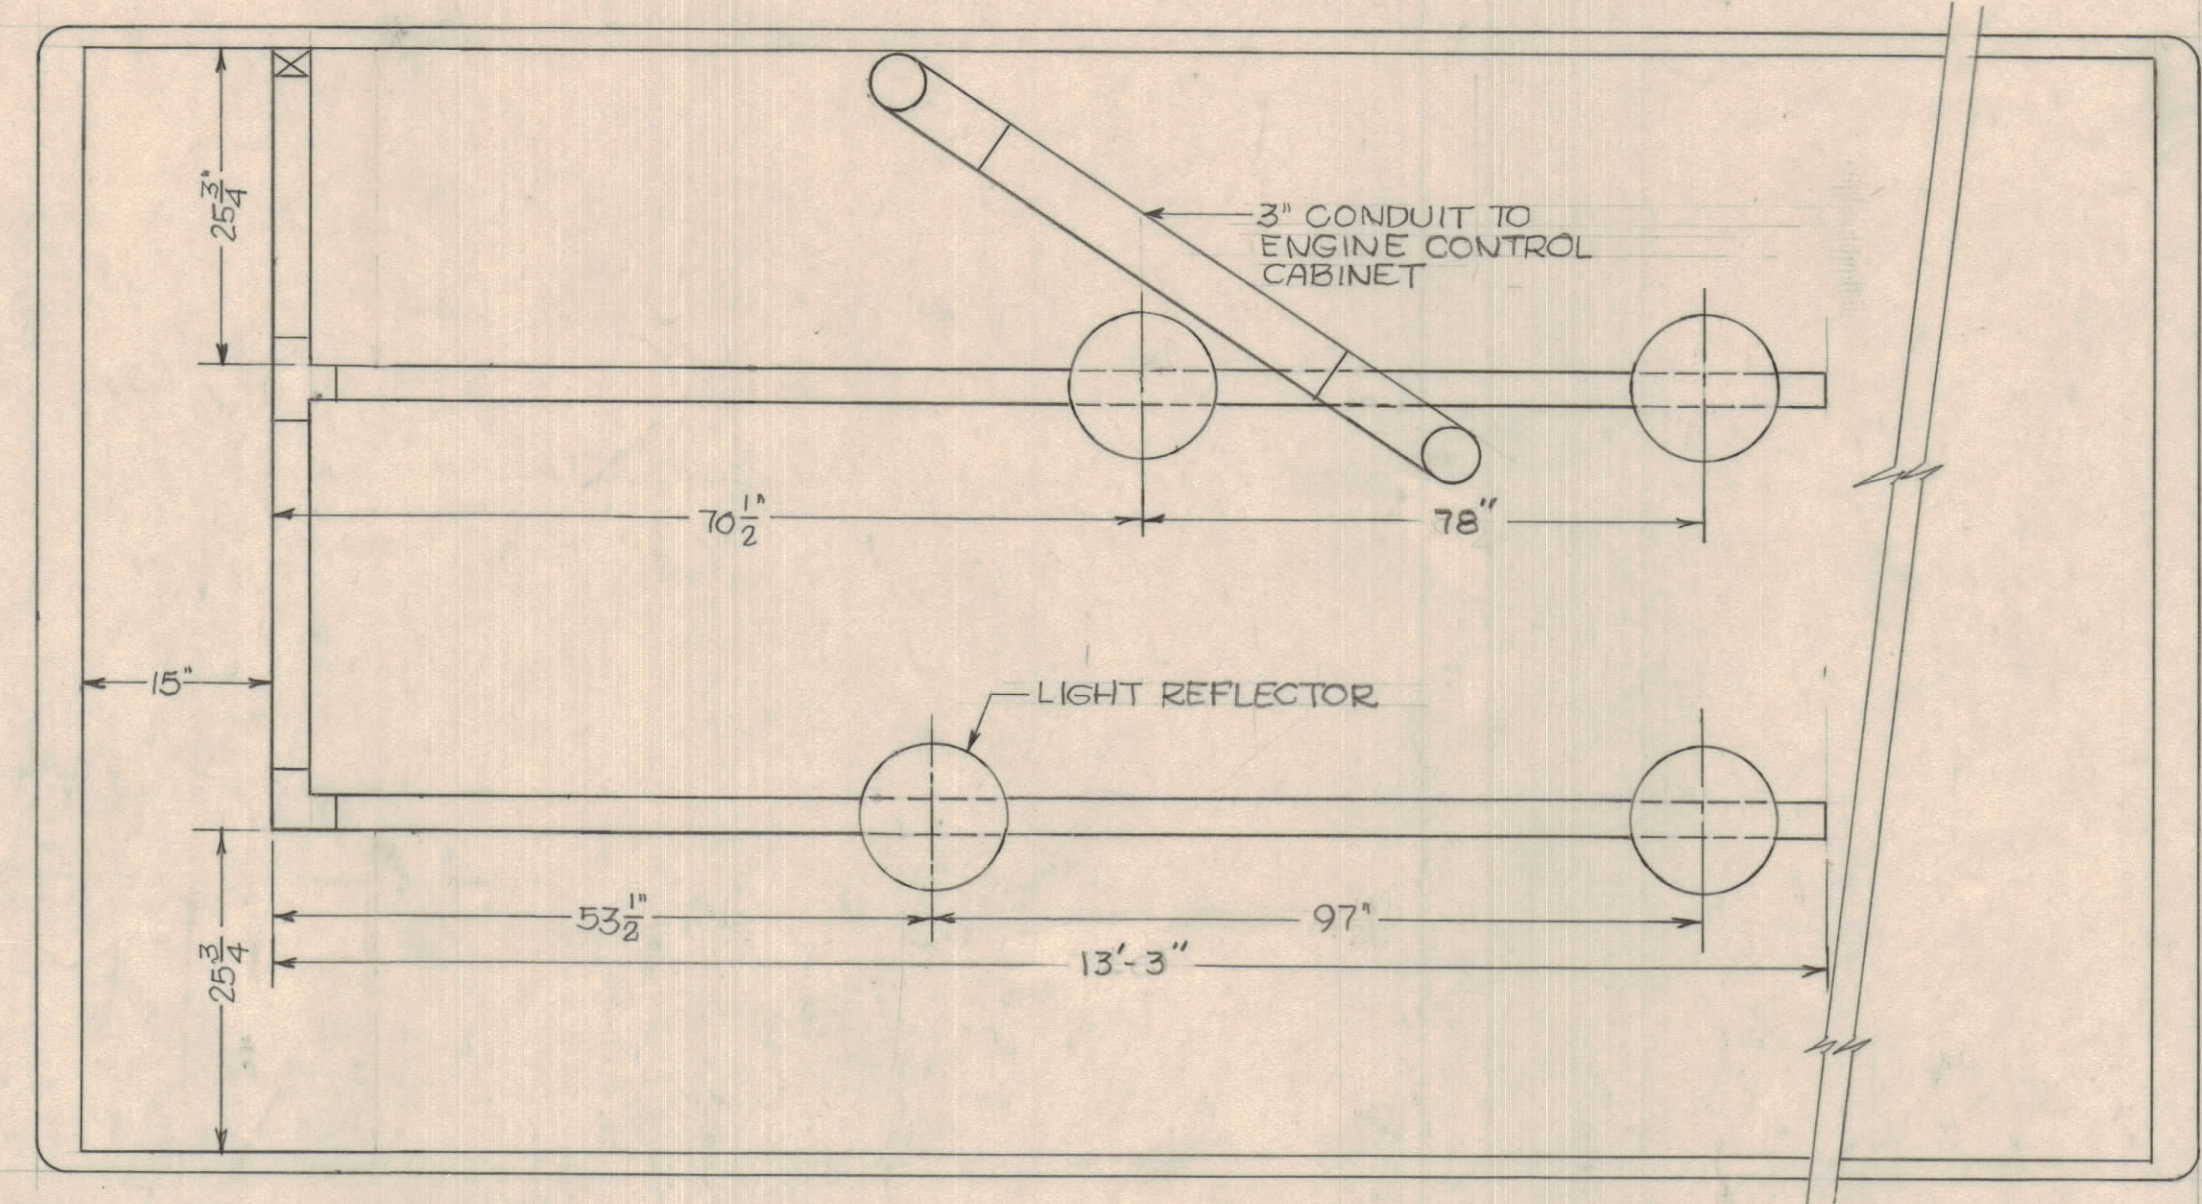

CEILING
VIEW FROM FLOOR

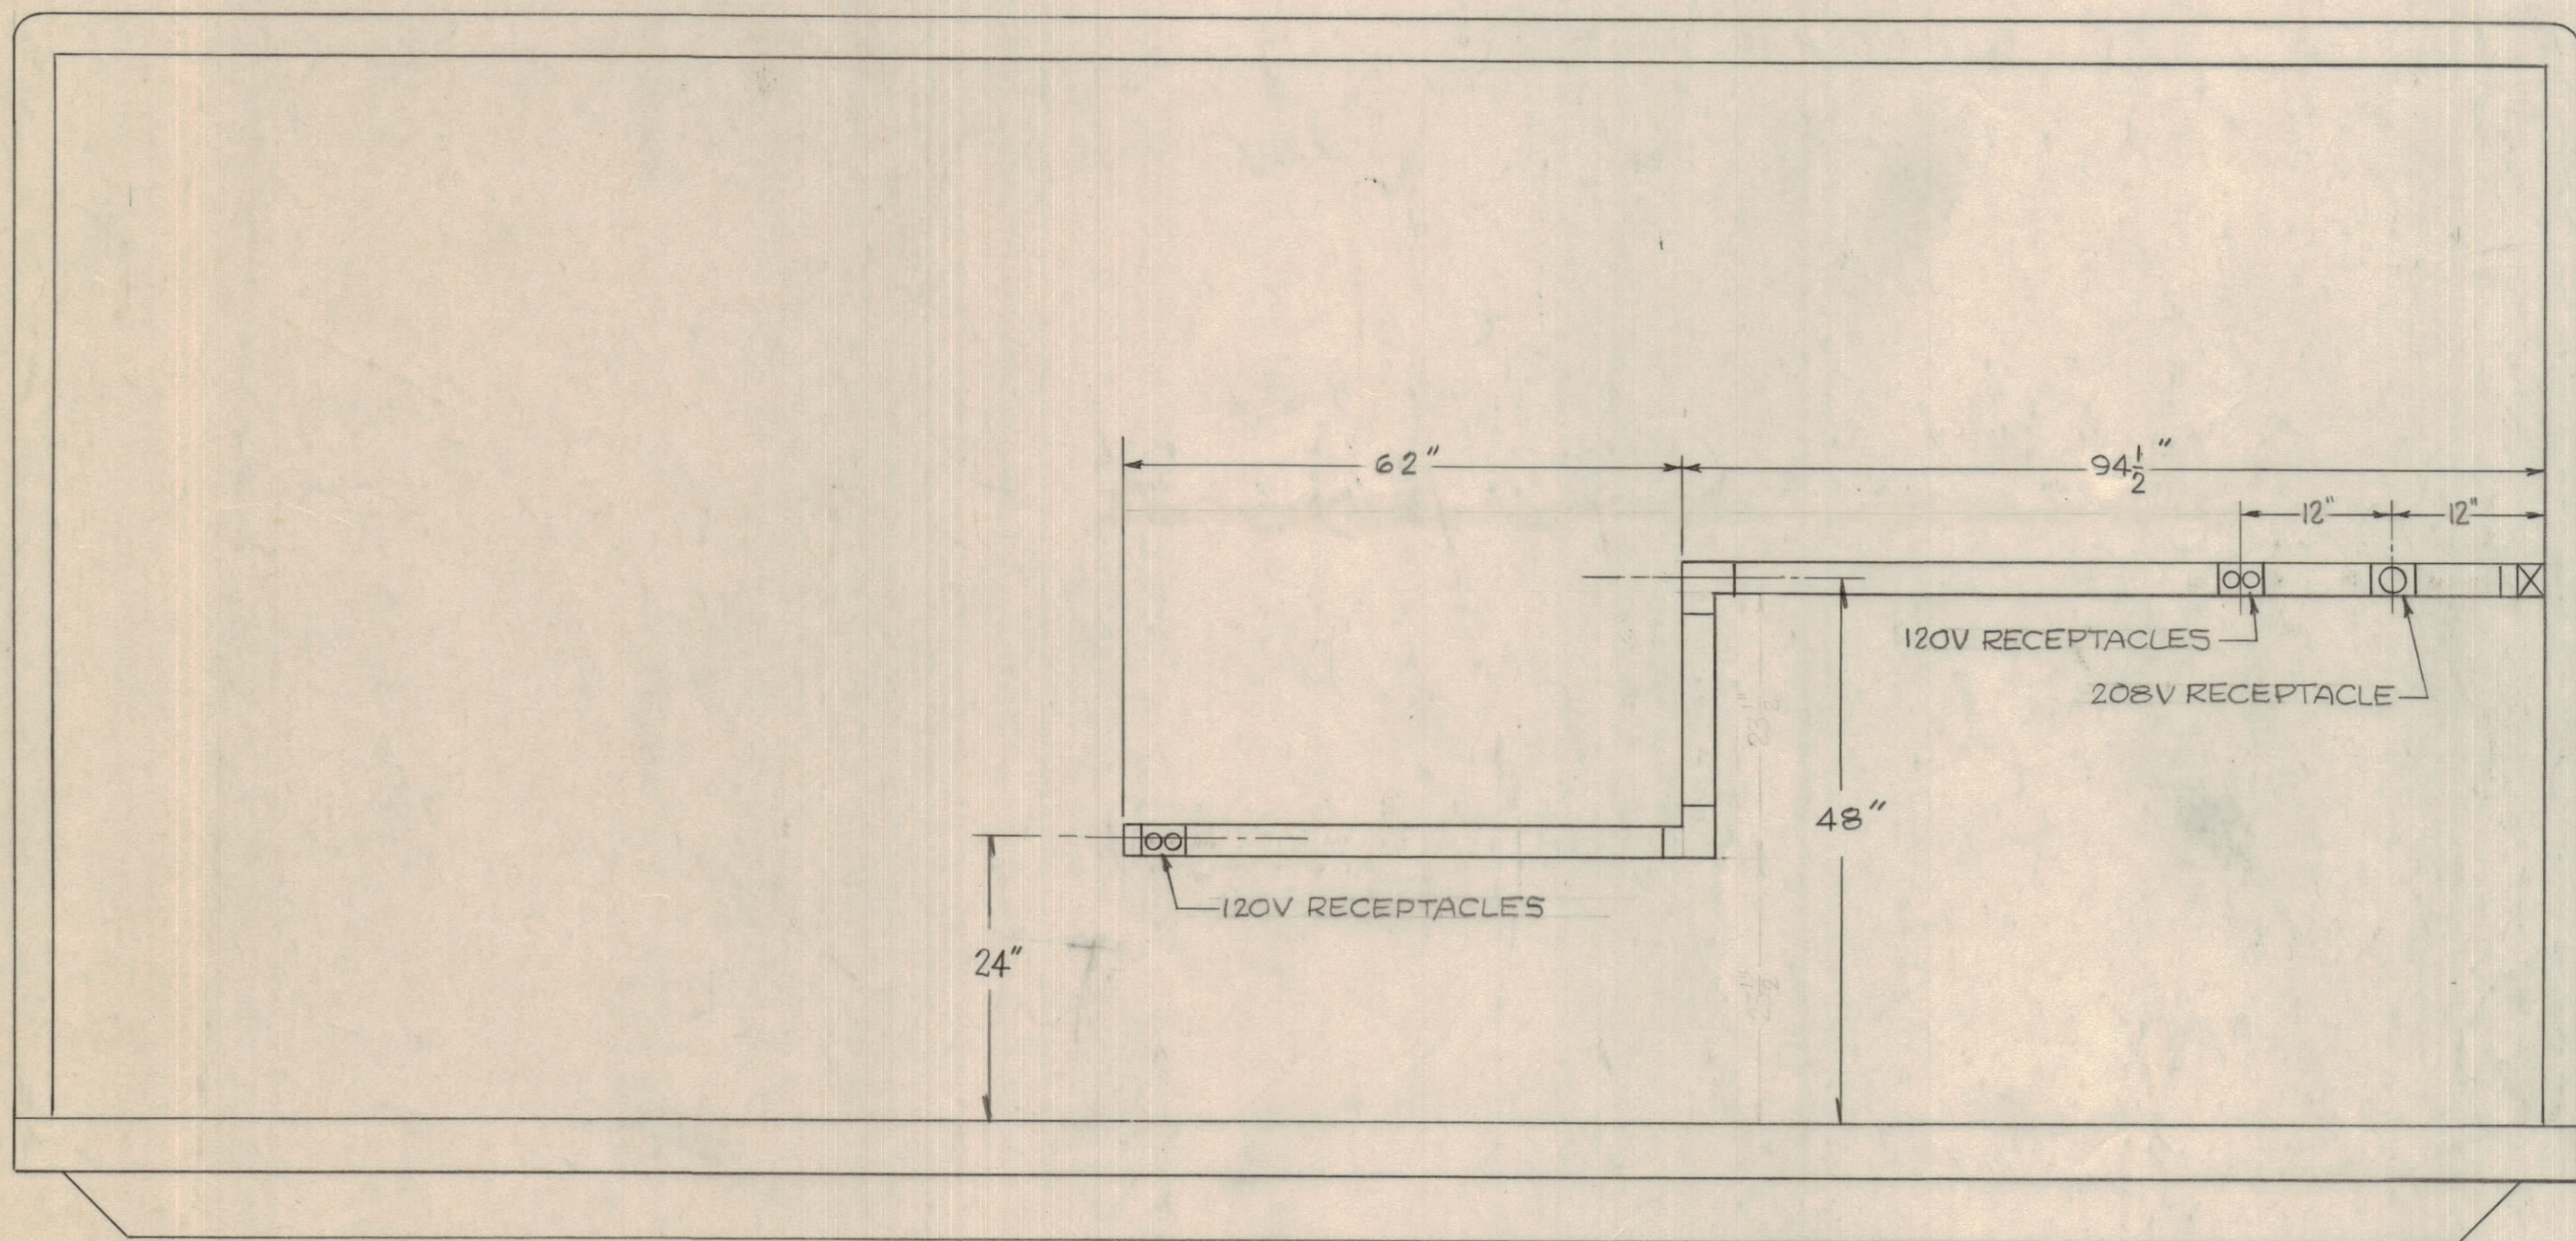

ROADSIDE

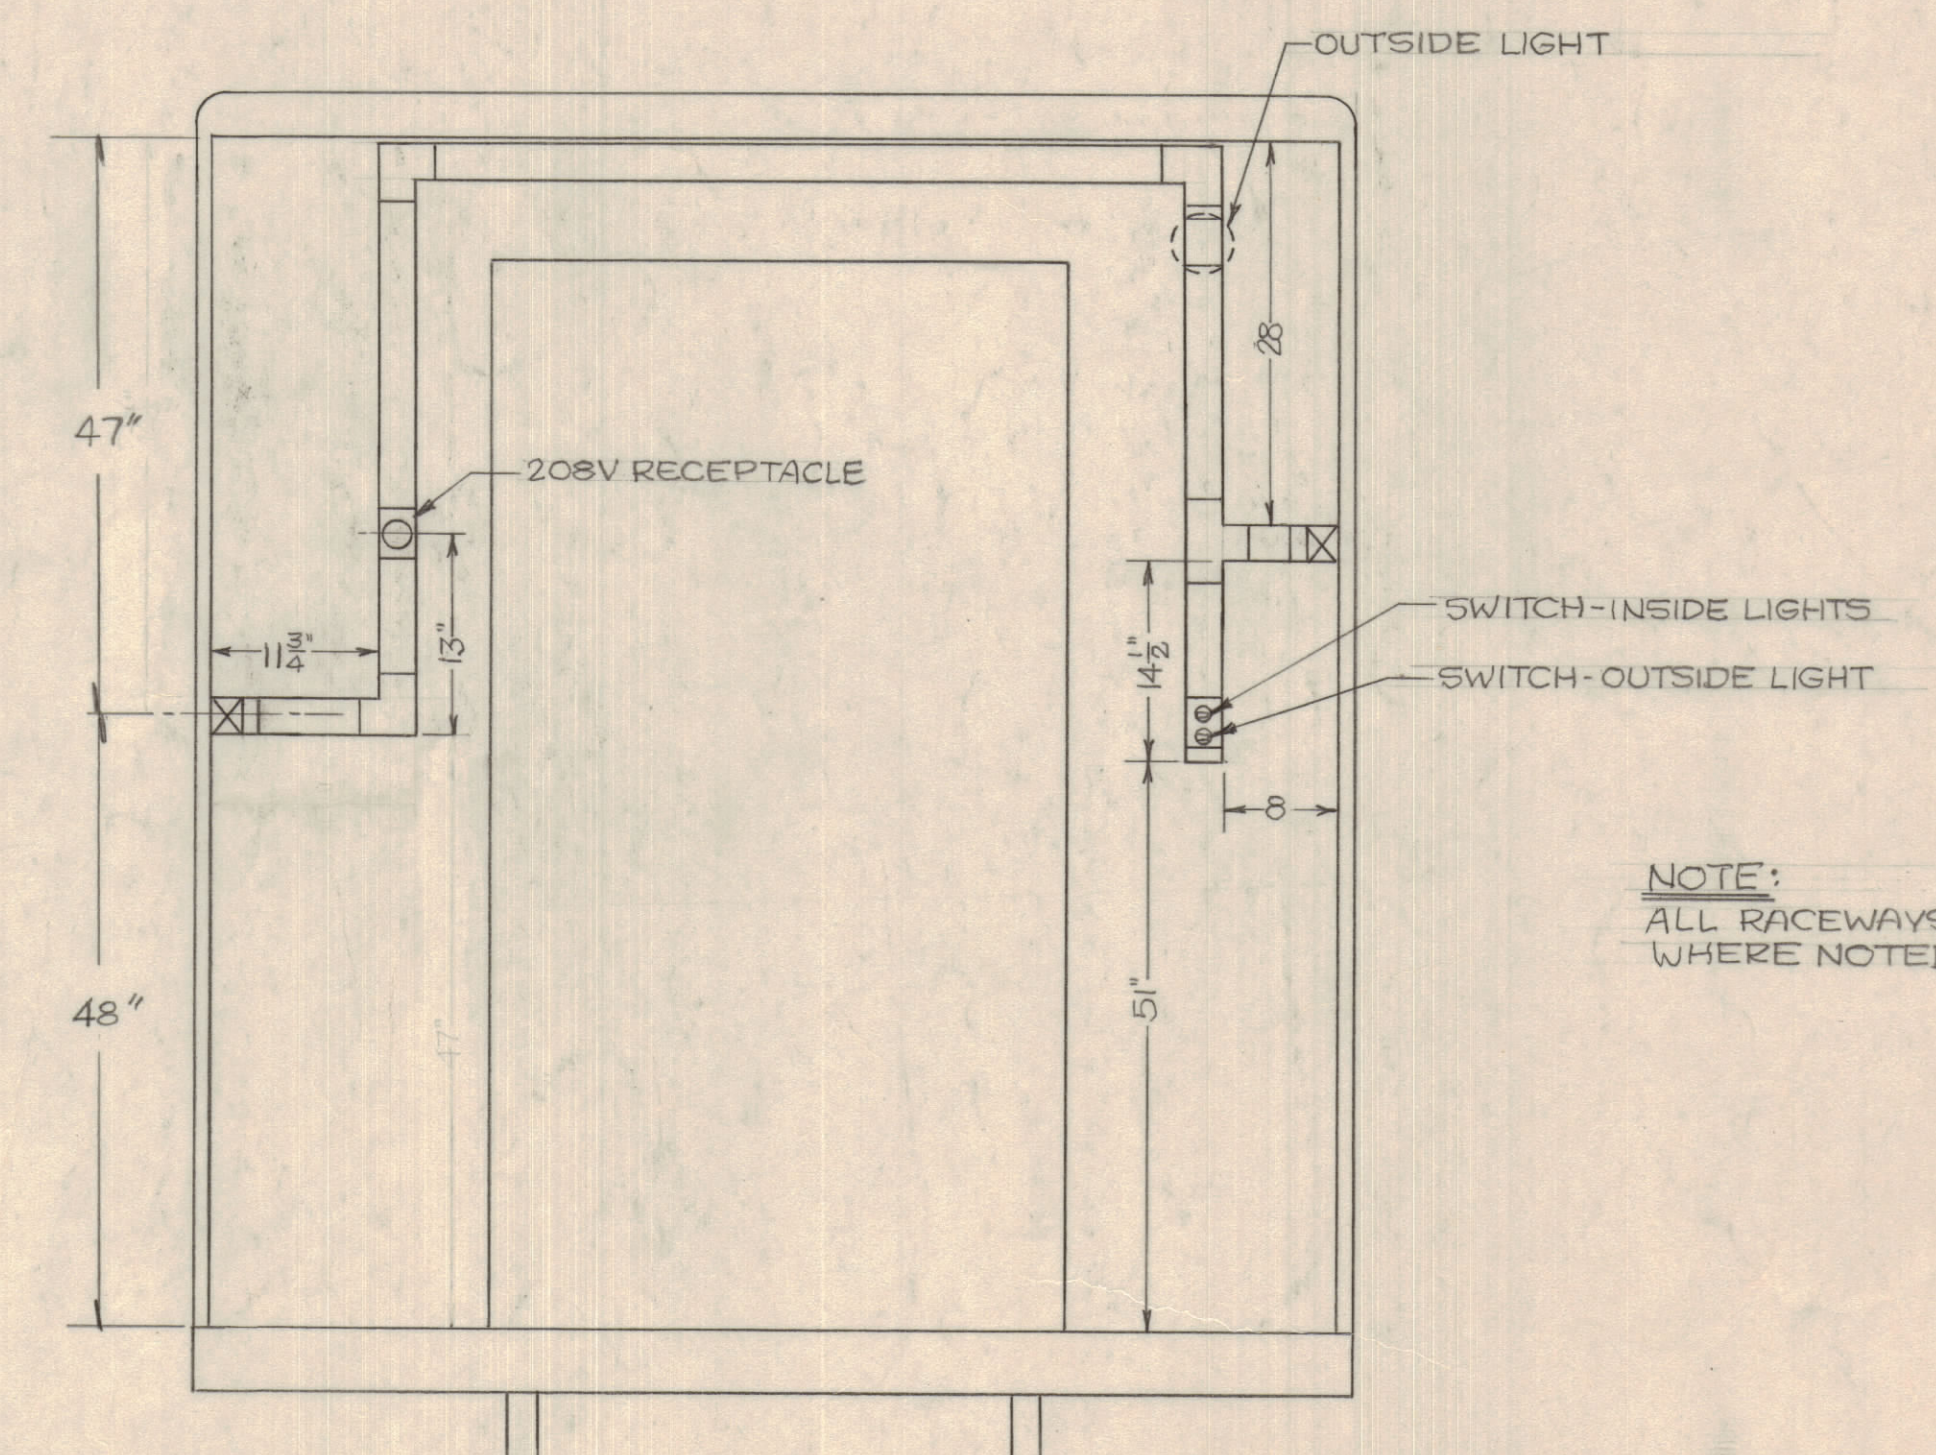

FRONT VIEW

NOTE:
ALL RACEWAYS ARE 2" EXCEPT
WHERE NOTED

QTY REQ	QTY REQ	QTY REQ	ITEM	PART NO.	MANUFACTURER	DESCRIPTION	SYM	
PARTS LIST								
DRAWN <i>FEZNADEZ</i>				DATE <i>3/10/73</i>	THE TMC SYSTEMS AND POWER CORPORATION SPRINGFIELD, VIRGINIA			
CHECKED <i>WJ</i>				DATE <i>6-15-73</i>				
D. ENG.				DATE				
P. ENG.				DATE	RACEWAY LOCATION			
P. MGR. <i>erB</i>				DATE <i>17 APR 73</i>				
CHIEF, ENG. DEPT.				DATE	SIZE D	CODE IDENT NO 24146	DWG. NO. 1D410	REV B
FINISH				SCALE NTS	SHEET 1 OF 1			

INTERPRET DRAWING PER LISTED DOCUMENTS

UNLESS OTHERWISE SPECIFIED DIMENSIONS ARE IN INCHES AND INCLUDE CHEMICALLY APPLIED OR PLATED FINISHES REMOVE ALL BURRS AND SHARP EDGES

TOLERANCES ON FRACTIONS ANGLES DECIMALS

MATERIAL

FINISH

NOTICE TO PERSONS RECEIVING THIS DRAWING THE TMC SYSTEMS AND POWER CORPORATION claims proprietary right in the material disclosed hereon. This drawing is issued in confidence for engineering information only and may not be reproduced or used to manufacture anything shown hereon without permission from THE TMC SYSTEMS AND POWER CORPORATION to the user. This drawing is loaned for mutual assistance and is subject to recall at any time.