


REQ. PER UNIT	USED ON			ED-375
	MODEL	ASS'Y. NO.	DATE	
1	SW-206	A-1489	12-24-57	

NP-375

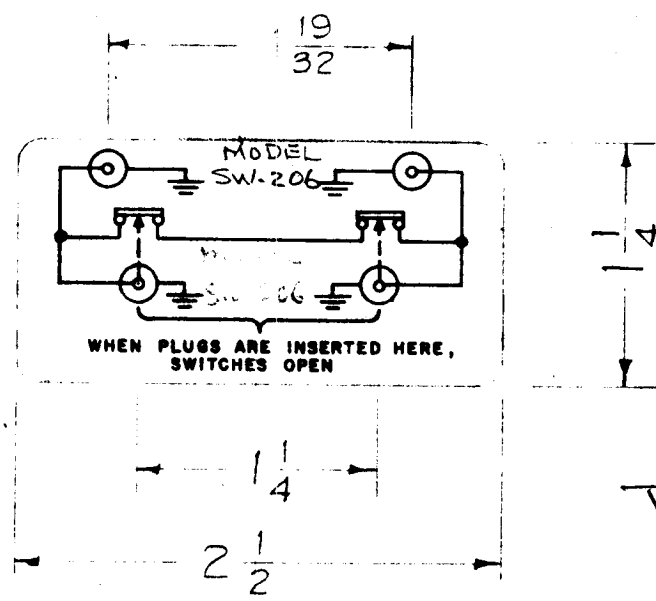

Replaced by
NP-225

NP-

Note: All lettering ~~and~~ symbols & borders to be black, ~~approx size shown~~. Background to be aluminum, *anodized*

Adhesive Backing

*Application: to painted surfaces
Painted Surface.*

							REQ. ITEM	PART NO.	DESCRIPTION	SYMBOL			
							003 to 005		THE TECHNICAL MATERIEL CORP. MAMARONECK, NEW YORK				
							STOCK SIZE		SCHMATIC DIAGRAM				
							Aluminum Foil.						
							MATERIAL						
ISSUE ITEM	CHANGED FROM	DATE	CH. NO.	DRAFTS	CHECKER	ENG. APP.	Anodized	K 12/24/57	W.C.	A.J.S.			
TOLERANCES		SCALE: FULL					TYPE & TEMPER	HEAT TREAT. SPEC.	DRAWN	CHECKED	FINAL APPROVAL		
DEC. DIM. ±		MAXIMUM ALLOWABLE TOLERANCES HAVE BEEN DETERMINED AND ANY DEVIATIONS WILL BE CAUSE FOR REJECTION. REMOVE ALL BURRS AND SHARP EDGES					SEE NOTE						
FRAC. DIM. ± 1/64							FINISH & SPEC. N		ELEC. DES. APP.	MECH. DES. APP.			
ANGULAR DIM. ±													

NP-375