

IF IT IS FOUND NECESSARY TO CHANGE ANY TOLERANCE OR OTHER DIMENSION SPECIFIED ON THIS DRAWING NOTIFY THE PURCHASER PROMPTLY.


MAXIMUM ALLOWABLE TOLERANCES HAVE BEEN DETERMINED AND DEVIATIONS WILL BE CAUSE FOR REJECTION. REMOVE ALL BURRS AND SHARP EDGES.

LAST SYMBOLS MISSING SYMBOLS
 CI10
 CB102
 TB101
 FI02
 DS104
 J102
 K103
 R122
 T102
 V107
 S103
 CR104

CHANGES NECESSARY TO CONVERT TO 230 V OPERATION

- T101 Remove jumpers marked ~~x~~ ~~x~~ ~~x~~ and connect jumper between terminals # 2 and 3.
- T102 Same as T101.
- CB101 Remove lead from terminals "C" and connect it to terminals "B".
- R104 Remove and discard jumper marked ~~x~~ ~~x~~ ~~x~~
- FI01 Change from 1 amp. to 1/2 amp.

Note:
 1. All fuses are slow blow.
 2. TB101 #5 and 6 normally jumpered unless remote interlocking is required.

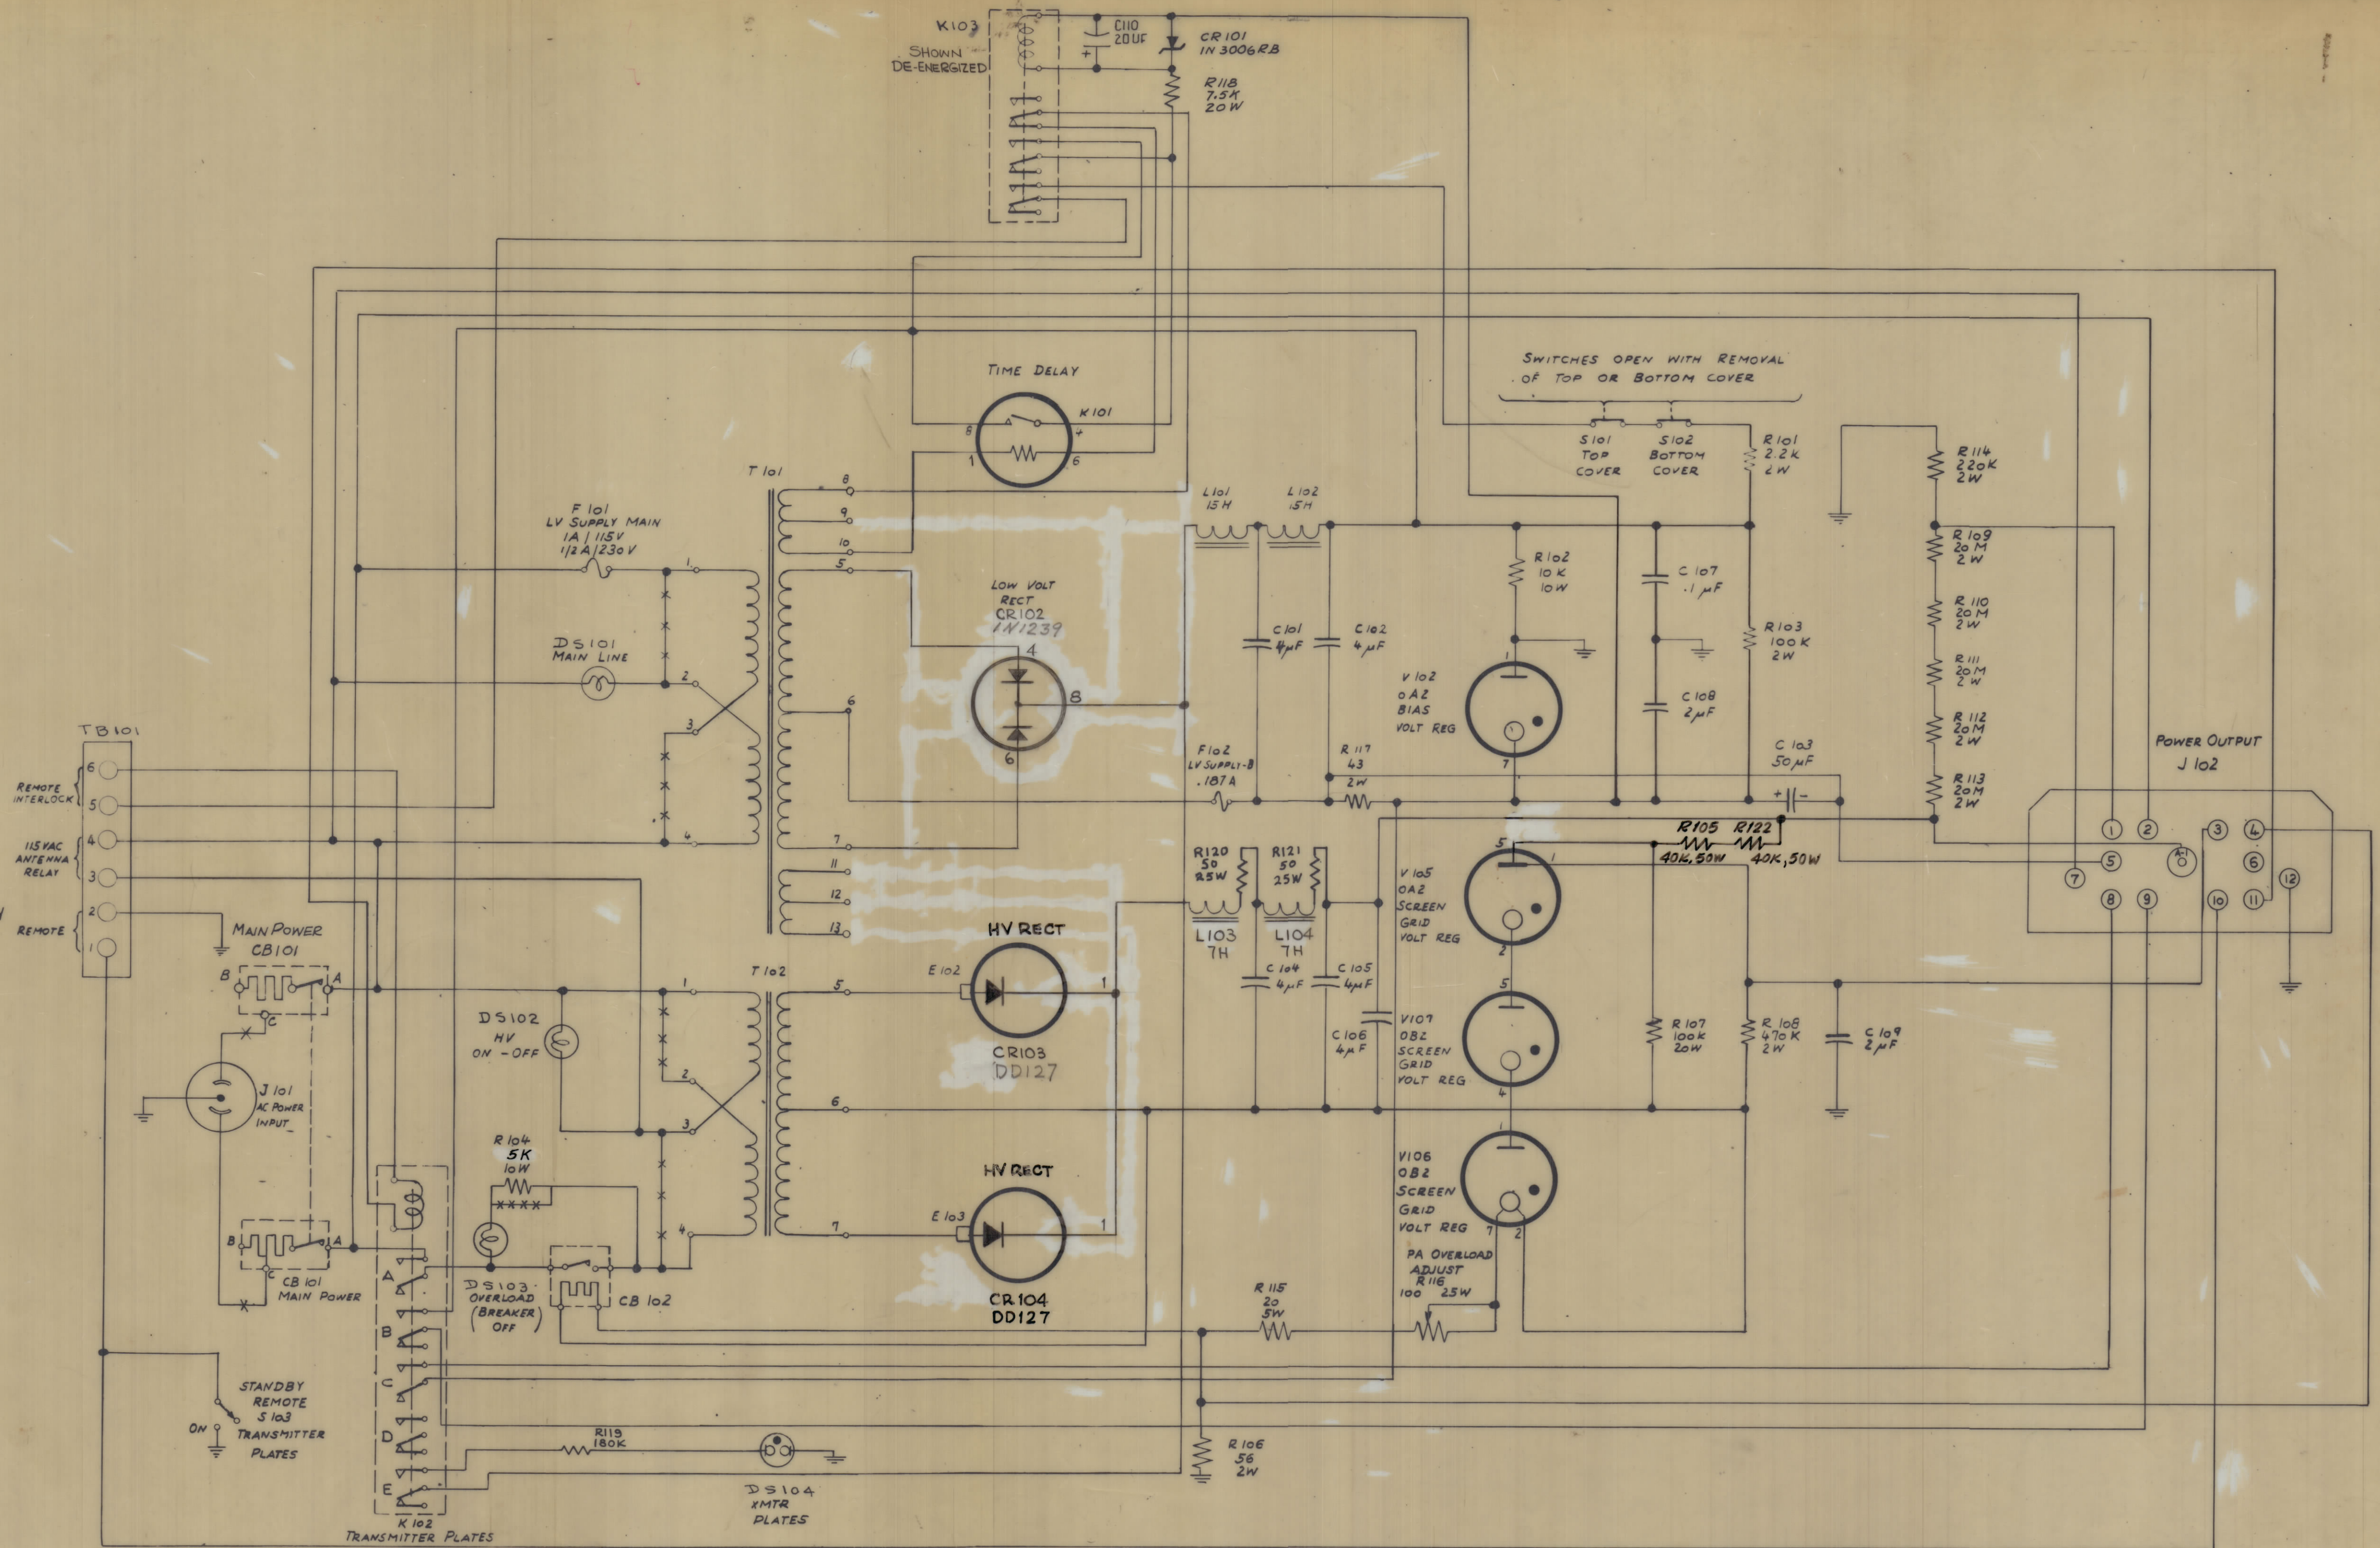

WARNING : Do NOT OPERATE THIS UNIT WITH V102 and/or V105 and/or V106 REMOVED!

B	ADD R122, Relocate R105	3/2/64	15967	H.A.		
A	R104, 5K WAS 4.5K	11/4/65	15142	H.A.		
Ø	ORIGINAL RELEASE FOR PRODUCTION	8/31/65	Ø	H.A.		
X1	CR102, 103, 104 PART #S CLARIFIED	8/30/65	X1	H.A.		
X	EXPERIMENTAL REL.	1/28/65	#	H.A.		
ISSUE	CHANGED FROM	DATE	CH. NO.	DRAFTS	CHECKER	ENG. APP.
TOLERANCES		SCALE:				
ALL OTHERS	DEC. DIM. ±	DRILL, PUNCH, COMMERCIAL STOCK SIZES AND MANUFACTURERS TOLERANCES ARE NOT INCLUDED.				
	ANGULAR DIM. ±					

PSP-350B	PROJECT NO.	DATE	4-27-65
MODEL	ASSY. NO.	DATE	
USED ON			

REV.	ITEM	PART NO.	DESCRIPTION	SYMBOL
THE TECHNICAL MATERIEL CORP. MAMARONECK, NEW YORK				
DIAGRAM, SCHEMATIC, ELEC.				
PSP-350B				
H.A.				
DRAWN: [Signature]				
CHECKED: [Signature]				
FINISH & SPEC. NO.				

CK967 B