HOLES	REQ'D
A – ~~—~~ DELETED	
B –	
C – .191-.194 DIA	9
D – .189 DIA	5
E – ~~7/64 DIA~~	~~2~~
F – 9/64 DIA	2
G – 7/32 DIA	6
H – 7/64 DIA	2
J – ~~.144 C'SK 82° TO .244 DIA~~	~~4~~
K – 5/16	1
L – 5/64	1

REVISIONS

ZONE	LTR	DESCRIPTION	DATE	E.M.N.NO	DRAFT	CHKD	APPD
	N	REDRAW W/CHANGES ORIGINAL LOST	9-24-90		GDL		
	P	TWO "G" HOLE WERE "D" HOLES	12-18-92		G.D.L		
	Q	11/16 DIM WAS 11/64	10-15-92		G.D.L		
	R	TWO "M" HOLES .144 C'SK DELETED ADD. TWO "C" HOLES	3-11-93		G.D.L		
	S	DIMENSION 13/32 WAS 1/2" DIMENSION 2 7/8 WAS 2.220 ± .010 15/32 WAS .475	3-18-93		G.D.L		
C-3	T	TWO "G" HOLES RELOCATED	6-17-93		G.D.L		

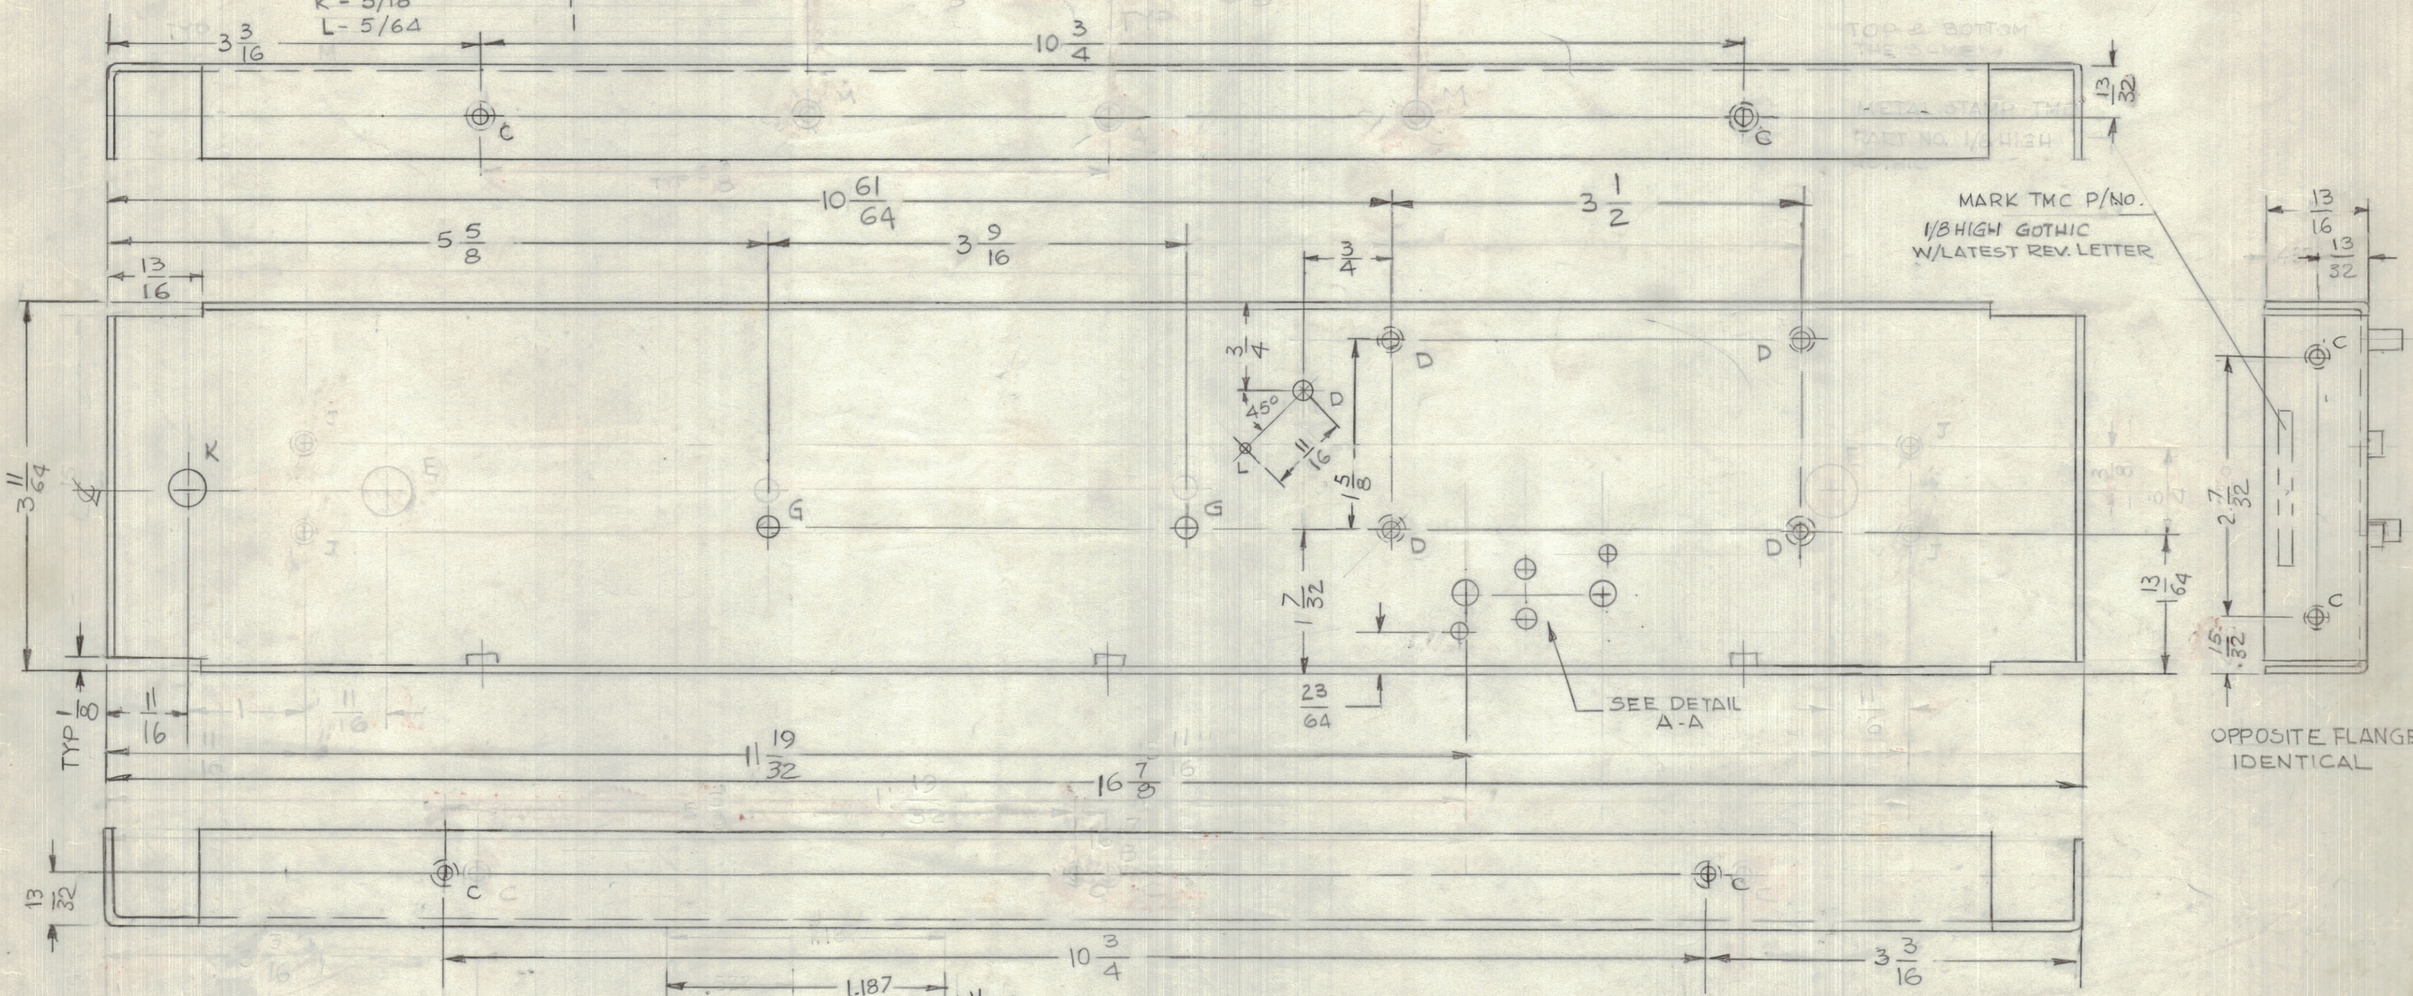

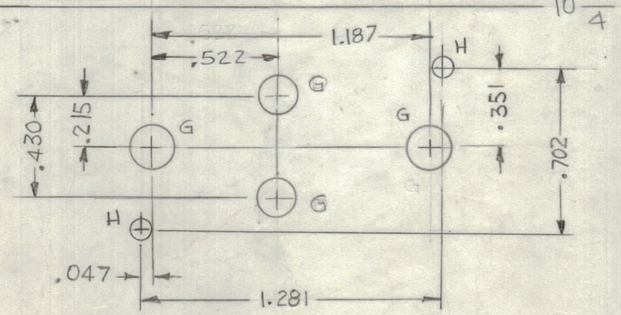

DETAIL "A-A" SCALE 2:1

QTY. REQ.	ITEM	PART NO.	DESCRIPTION	SYMBOL
9	4	NT129-0632-4	NUT, ROUND	C
~~4~~	~~2~~	~~DELETED~~	~~NUT, ROUND~~	~~T~~
4	1	TE164-11	NUT, PLAIN CLINCH 3/8 LG	D

LIST OF MATERIAL

1	AMC-32A
QTY / UNIT	MODEL USED ON

ASS'Y NO.

APPLICATION

CODE

NOTICE TO PERSONS RECEIVING THIS DRAWING
THE TECHNICAL MATERIEL CORPORATION claims proprietary right in the material disclosed hereon. This drawing is issued in confidence for engineering information only and may not be reproduced or used to manufacture anything shown hereon without permission from THE TECHNICAL MATERIEL CORPORATION to the user. This drawing is loaned for mutual assistance and is subject to recall at any time.

UNLESS OTHERWISE SPECIFIED DIMENSIONS ARE IN INCHES AND INCLUDE CHEMICALLY APPLIED OR PLATED FINISHES

TOLERANCES ON

DECIMALS	FRACTIONS
.X ± .05	± 1/64
.XX ± .01	ANGLES
.XXX ± .005	± 0° 30′

MATERIAL .064 THK AL AL-5052-H32

FINISH 5404 YEL IRIDITE

FINAL APPROVAL		DATE
MECH. DES.		DATE
ELECT. DES.		DATE
CHECKED		DATE
DRAWN	G.D.L	DATE 9-24-90

THE TECHNICAL MATERIEL CORP.
MAMARONECK, NEW YORK

SHIELD

SIZE	CODE IDENT. NO.	DWG NO.	ISSUE
C	82679	MS10948	T
SCALE 1:1		SHEET	OF

10948 T

FC1-10-170 (10-68)

130309