HOLE	DESCRIPTION	REQ
A	13/64 DIA.	4

REQ. PER UNIT	USED ON MODEL	ASS'Y. NO.	DATE
4	KIT 271		10-21-64
4	KIT 272		

MS4784 Ø

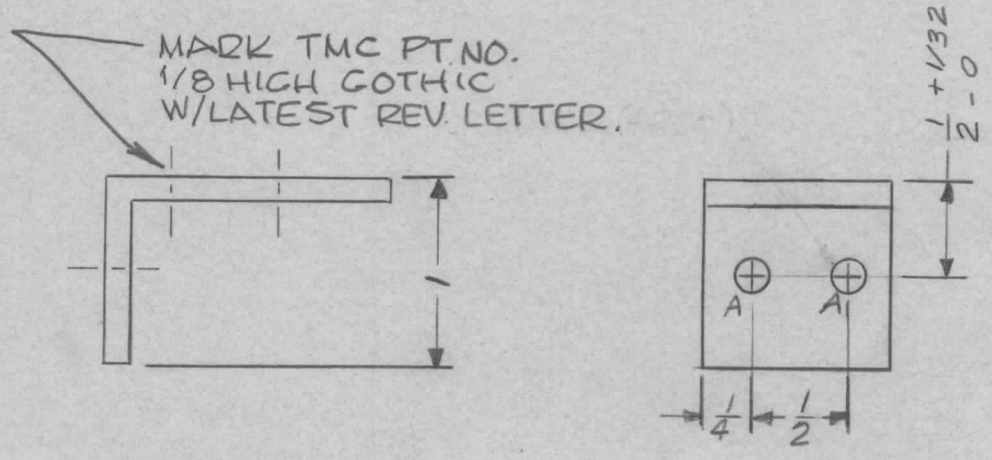

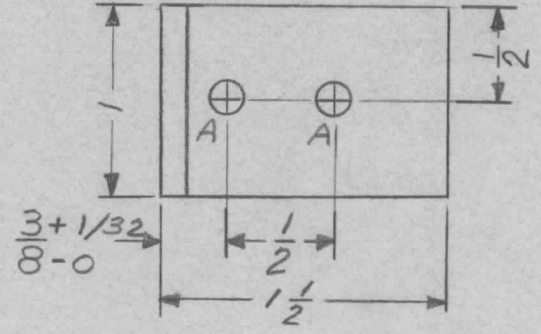

UNLESS OTHERWISE SPECIFIED:

1. USE MATERIAL THICKNESS FOR MAXIMUM RADIUS ON ALL BENDS
2. ALL ANGULAR BENDS 90 DEGREES
3. REMOVE ALL BURRS AND SHARP EDGES

SYM	DESCRIPTION	DATE	CH. NO.	DRAFTS	CHECKER	ENG. APP.
Ø	ORIGINAL RELEASE FOR PRODUCTION	11/4/65	Ø	V.V.V.		
X	DIM. BETW. HOLE WAS 3/8 CLWR VIEW) "A" HOLES WERE 3/16 D.	11/3/65	~~11~~	DVV		

UNLESS OTHERWISE SPECIFIED
DIMENSIONS ARE IN INCHES AND INCLUDE CHEMICALLY APPLIED OR PLATED FINISHES

TOLERANCES
DECIMALS .X ± .05, .XX ± .01, .XXX ± .005
FRACTIONS ± 1/64
ANGLES ± 0° 30'

SCALE: DO NOT SCALE.

CODE

REQ.	ITEM	PART NO.
1		X 1 1/2 X 1/8 ∠

STOCK SIZE

ALUMINUM

MATERIAL

5052 H32

TYPE & TEMPER

HEAT TREAT. SPEC.

YEL IRIDITE ~~S404~~

FINISH & SPEC. NO.

STURMER DESCRIPTION

SYMBOL

THE TECHNICAL MATERIEL CORP.
MAMARONECK. NEW YORK

BRACKET, MTG., SUPPORT

DRAWN	CHECKED	FINAL APPROVAL
D.V.V. 10-29-65	QCK	11/4/65

ELEC. DES. APP.	MECH. DES. APP.	
	11/2/65	MS4784 Ø

TMC FORM 108-A

REPROVEL NO. 440H

21540